


First Floor Office Plan

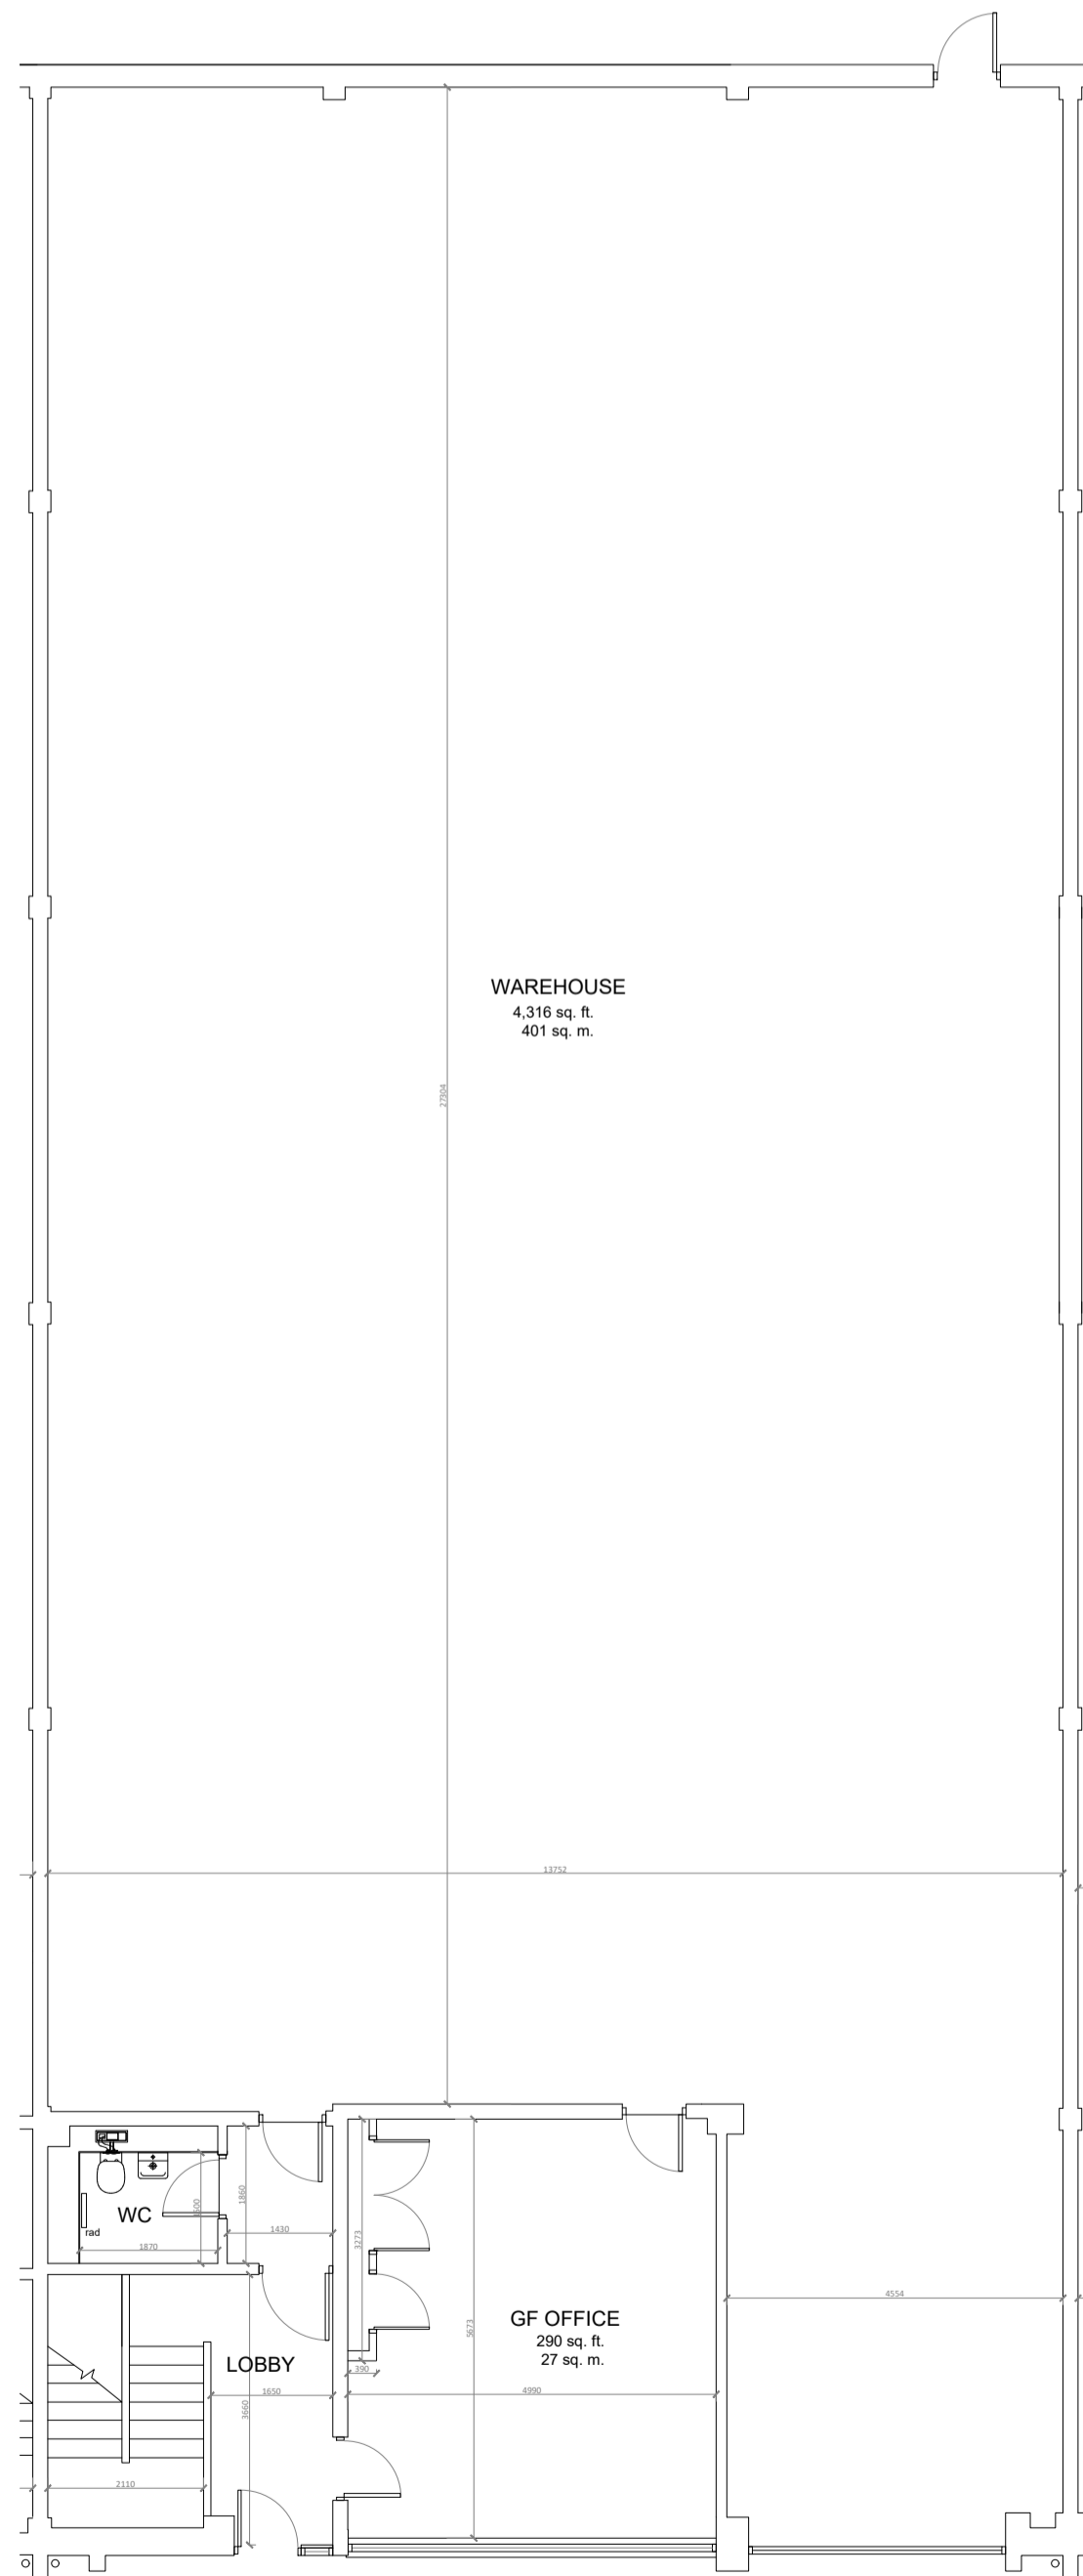

Ground Floor Plan

REVISION	DATE	DESCRIPTION
STATUS	SIGNED	DATE
INFORMATION	-	
APPROVAL	-	
CONSTRUCTION	-	
AS BUILT	-	
WELBRO PROJECT MANAGEMENT LTD 71 St MARGARET'S LANE TITCHFIELD HAMPSHIRE PO14 4BG TEL 01329 846076 FAX 01329 846077		
SITE Unit 2 Havelock Terrace Nine Elms, SW8		
ELEMENT Floor Plans - Unit 2 As Built		
W	E	L P M
DATE	06/06/2023	REVISION
		AB
DRAWN	SZ	CHECKED
		JRS
SIZE	A1	SCALE
		1:100
DO NOT SCALE-IF IN DOUBT CONTACT THE ABOVE OFFICE		