


First Floor Office Plan

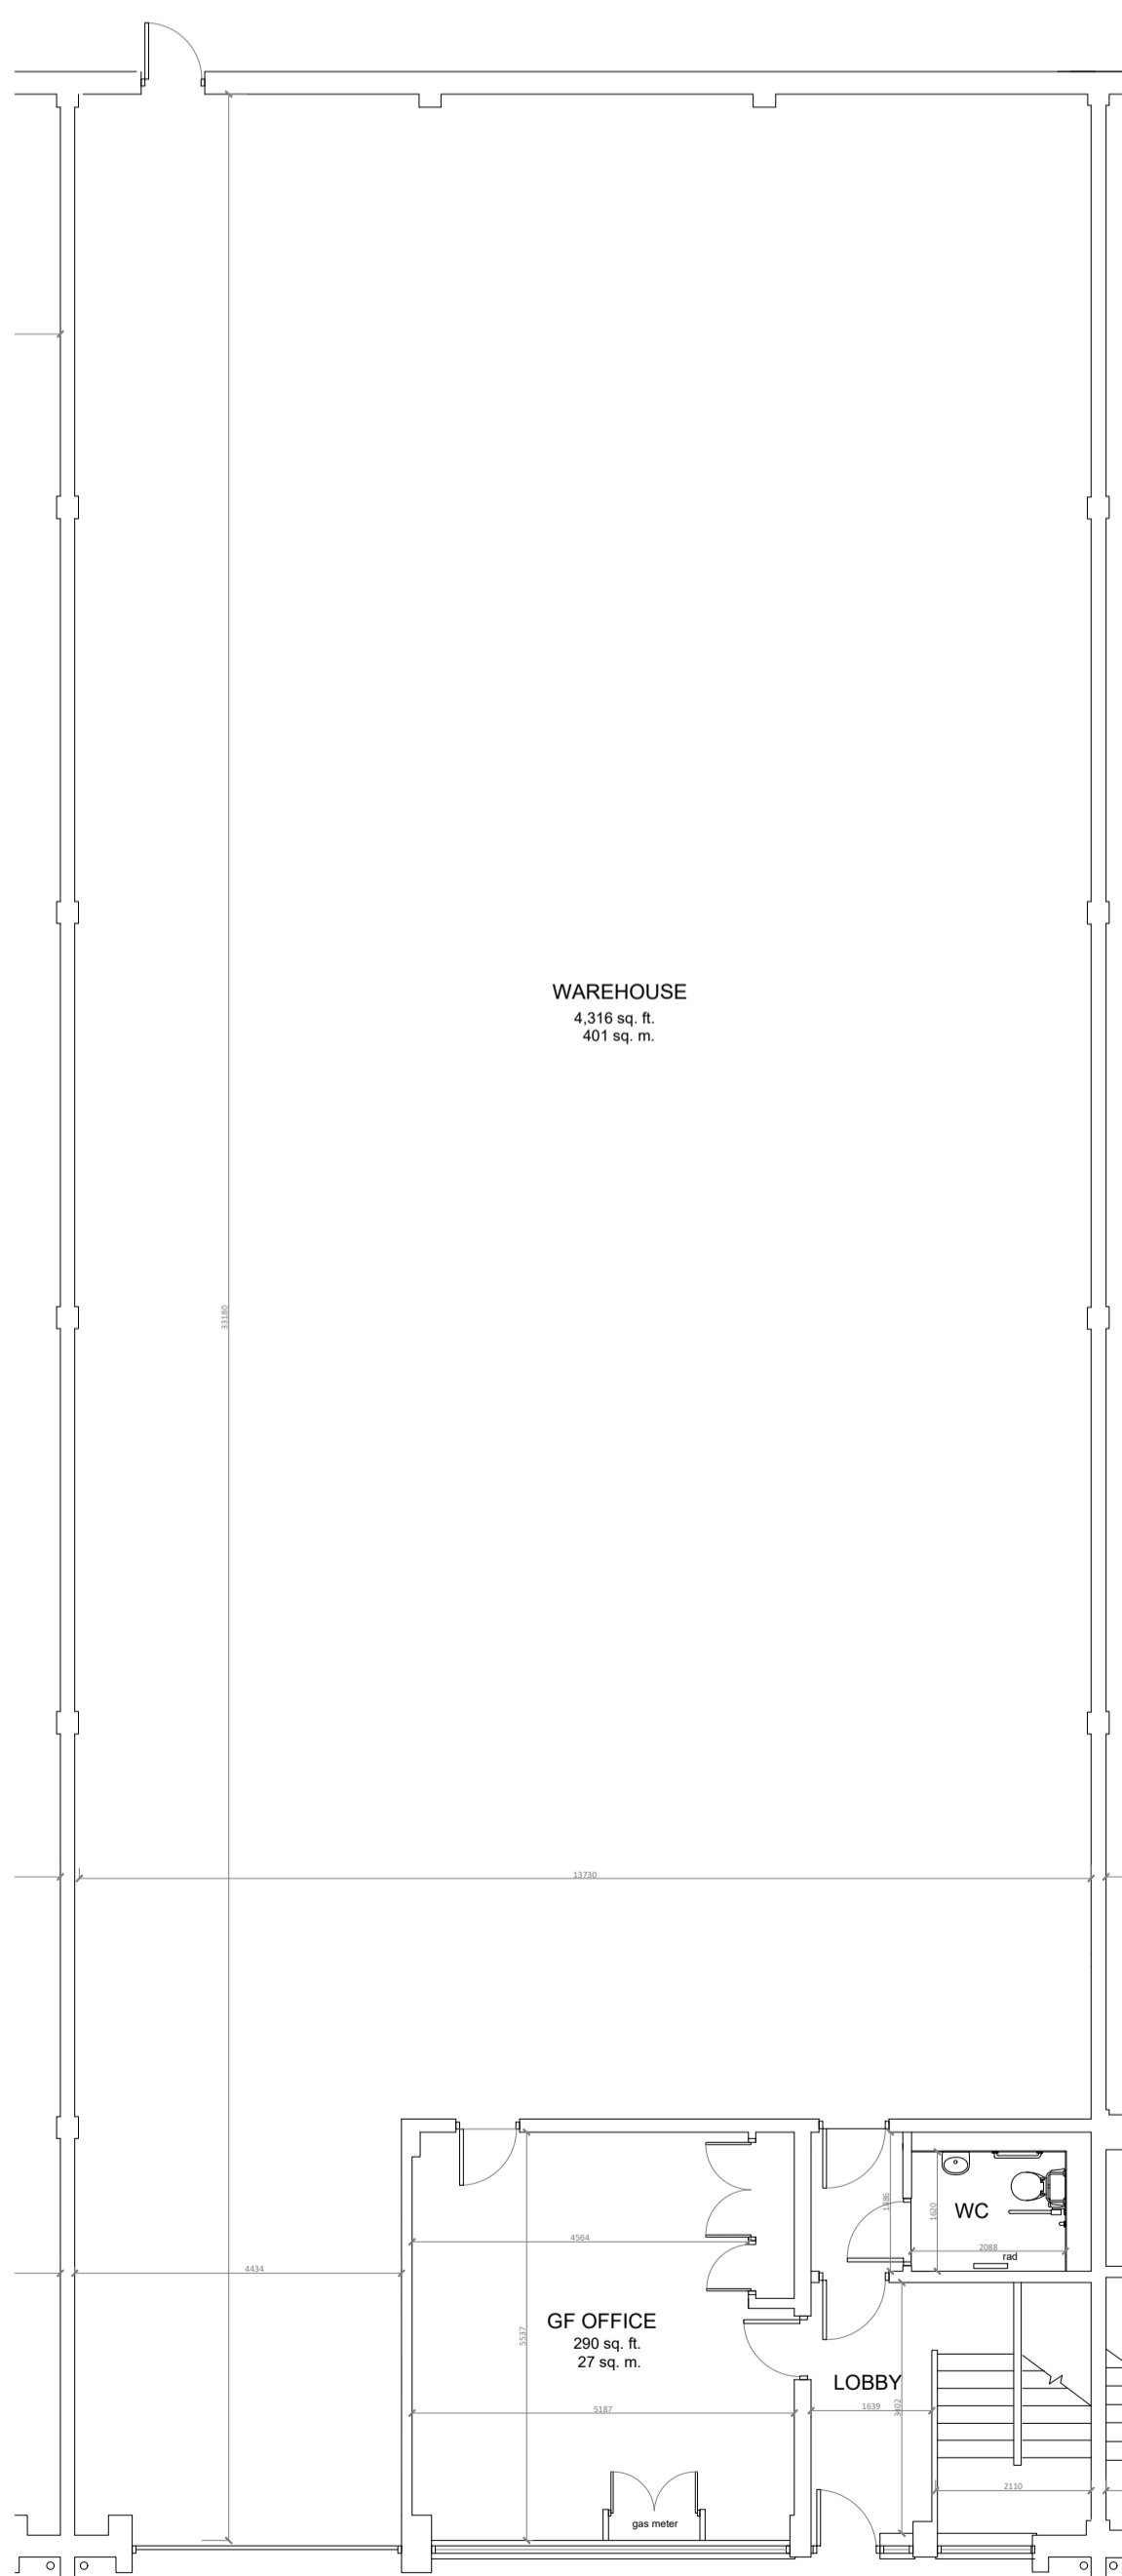

Ground Floor Plan

REVISION	DATE	DESCRIPTION
STATUS	SIGNED	DATE
INFORMATION	-	
APPROVAL	-	
CONSTRUCTION	-	
AS BUILT	-	
WELBRO PROJECT MANAGEMENT LTD 71 St MARGARET'S LANE TITCHFIELD HAMPSHIRE PO14 4BG TEL 01329 846076 FAX 01329 846077		
SITE Unit 3 Havelock Terrace Nine Elms, SW8		
ELEMENT Floor Plans - Unit 3 As Built		
W E L P M	PM2482	
DATE	21/07/2023	REVISION AB
DRAWN	SZ	CHECKED JRS
SIZE	A1	SCALE 1:100
DO NOT SCALE-IF IN DOUBT CONTACT THE ABOVE OFFICE		