


First Floor Office Plan

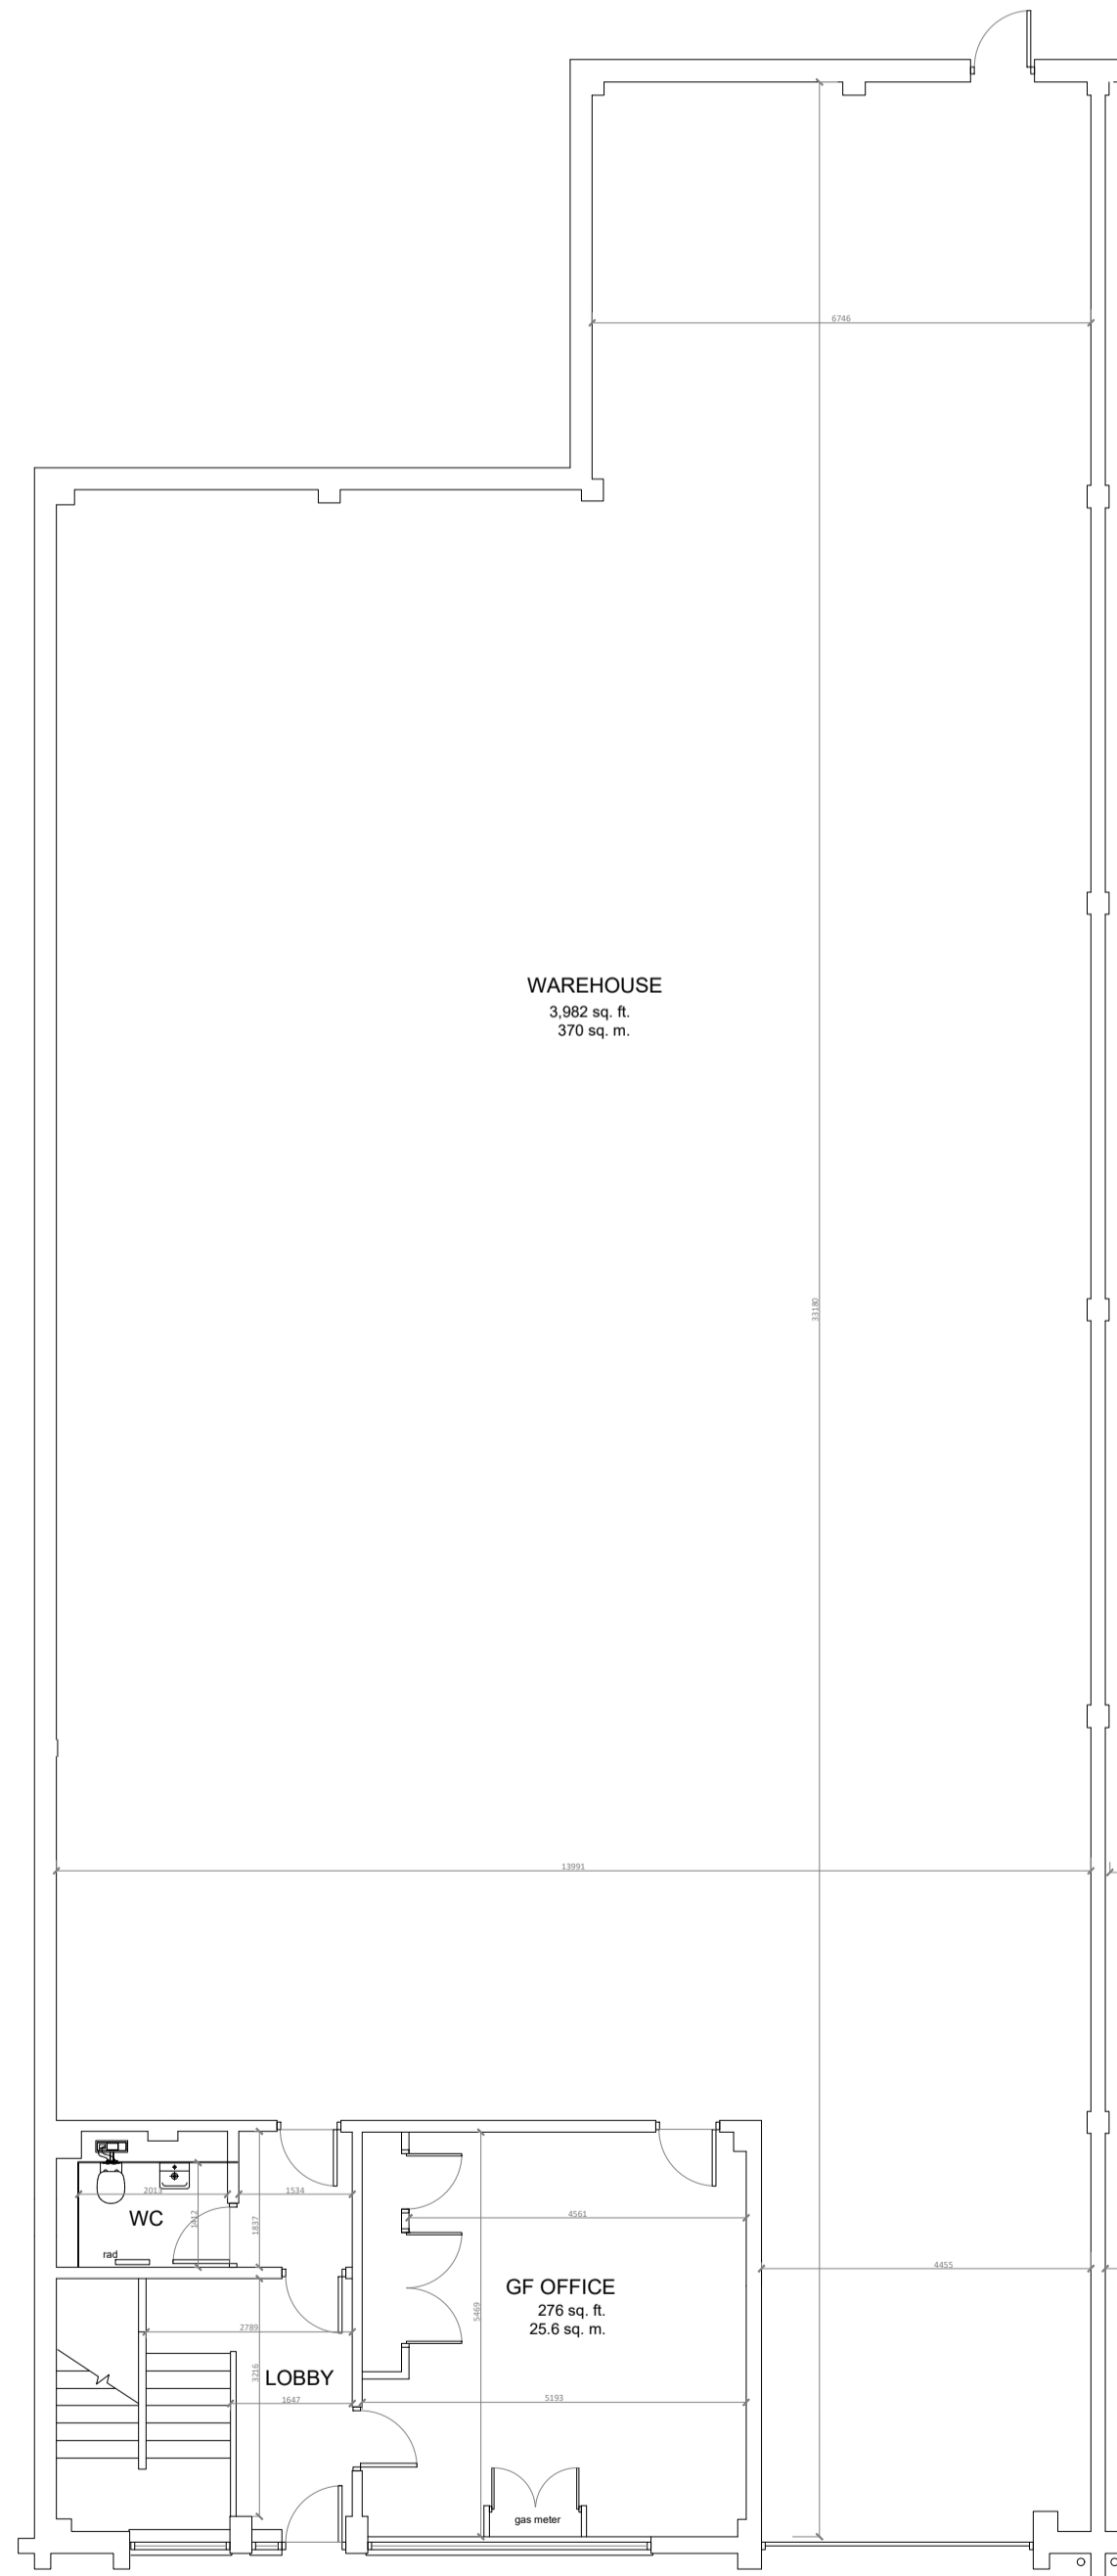

Ground Floor Plan

| REVISION | DATE | DESCRIPTION |
|---|---------------|--------------------|
| | | |
| STATUS | SIGNED | DATE |
| INFORMATION | - | |
| APPROVAL | - | |
| CONSTRUCTION | - | |
| AS BUILT | - | |
| WELBRO PROJECT MANAGEMENT LTD 71 St MARGARET'S LANE TITCHFIELD HAMPSHIRE PO14 4BG TEL 01329 846076 FAX 01329 846077 | | |
| SITE Unit 4 Havelock Terrace Nine Elms, SW8 | | |
| ELEMENT Floor Plans - Unit 4 As Built | | |
| WELPM | PM2482 | |
| DATE | 21/07/2023 | REVISION AB |
| DRAWN | SZ | CHECKED JRS |
| SIZE | A2 | SCALE 1:100 |
| DO NOT SCALE-IF IN DOUBT CONTACT THE ABOVE OFFICE | | |