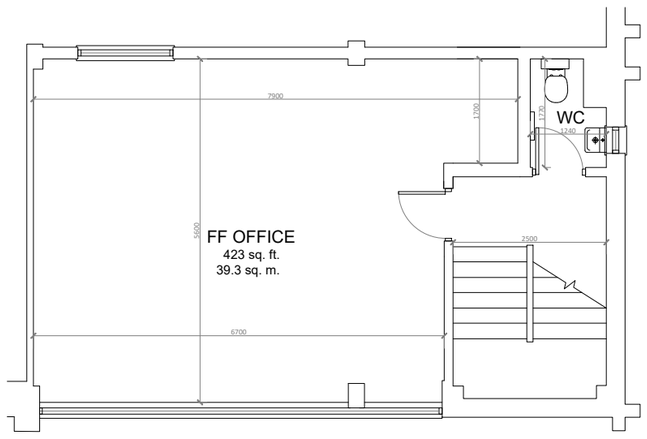

First Floor Office Plan

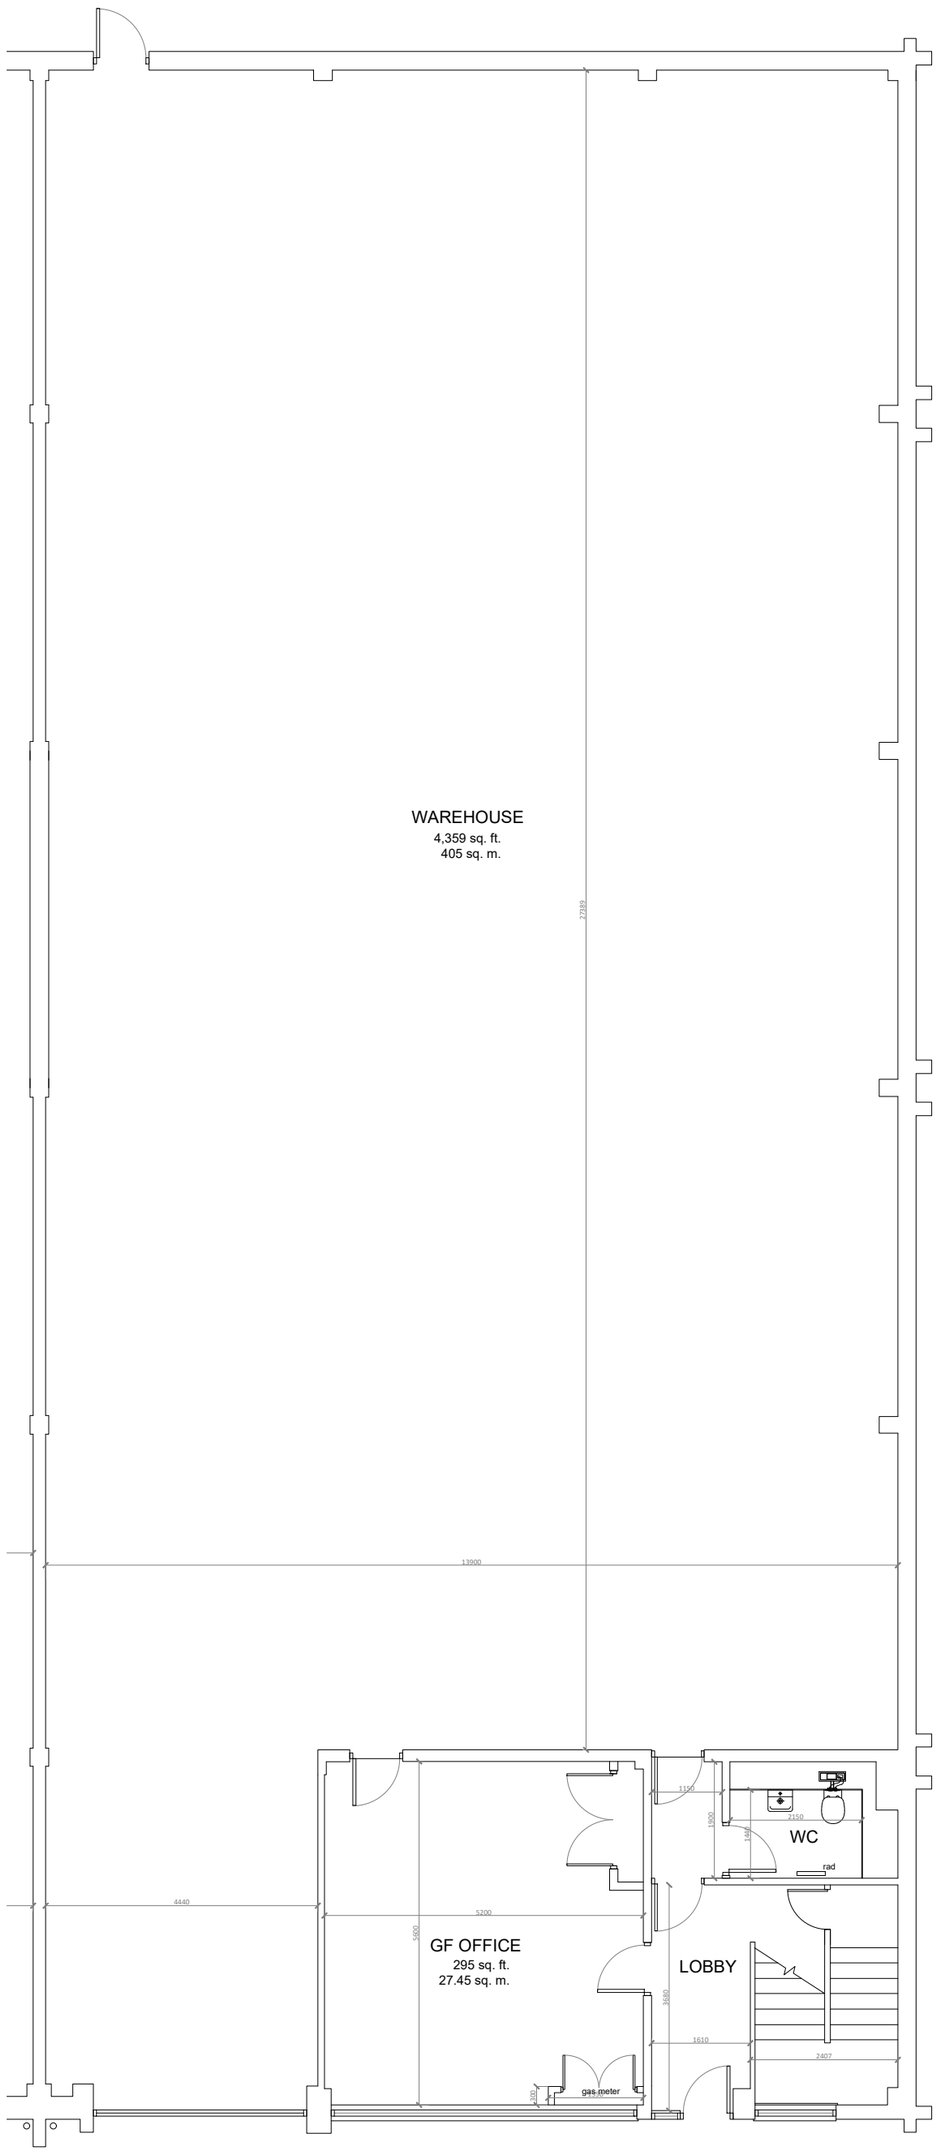

Ground Floor Plan

REVISION	DATE	DESCRIPTION

STATUS	SIGNED	DATE
INFORMATION	-	
APPROVAL	-	
CONSTRUCTION	-	
AS BUILT	-	

WELBRO
PROJECT MANAGEMENT LTD
71 St MARGARET'S LANE
TITCHFIELD
HAMPSHIRE
PO14 4BG

TEL 01329 846076
FAX 01329 846077

SITE
Unit 1
Havelock Terrace
Nine Elms, SW8

ELEMENT
Floor Plans - Unit 1
As Built

W	E	L	P	M	PM2482

DATE	06/06/2023	REVISION	AB
DRAWN	SZ	CHECKED	JRS
SIZE	A1	SCALE	1:100

DO NOT SCALE-IF IN DOUBT
CONTACT THE ABOVE OFFICE